

# ELEVATION CERTIFICATE


OMB No. 1660-0008  
Expires March 31, 2012


Important: Read the instructions on pages 1-9.

SECTION A - PROPERTY INFORMATION		For Insurance Company Use:
A1. Building Owner's Name Vinod Rustgi	Policy Number	
A2. Building Street Address (including Apt., Unit, Suite, and/or Bldg. No.) or P.O. Route and Box No. 1240 Marlin Court City Marco Island State FL ZIP Code 34145	Company NAIC Number	
( 11-5073 )		
A3. Property Description (Lot and Block Numbers, Tax Parcel Number, Legal Description, etc.) Lot 10, Block 325, MARCO BEACH, UNIT TEN, COLLIER COUNTY		
A4. Building Use (e.g., Residential, Non-Residential, Addition, Accessory, etc.) <u>Residential</u>		
A5. Latitude/Longitude: Lat. <u>N25°55'13.8"</u> Long. <u>W81°43'00.0"</u>		Horizontal Datum: <input type="checkbox"/> NAD 1927 <input checked="" type="checkbox"/> NAD 1983
A6. Attach at least 2 photographs of the building if the Certificate is being used to obtain flood insurance.		
A7. Building Diagram Number <u>6</u>		
A8. For a building with a crawlspace or enclosure(s):		A9. For a building with an attached garage:
a) Square footage of crawlspace or enclosure(s) <u>832</u> sq ft	a) Square footage of attached garage <u>N/A</u> sq ft	b) No. of permanent flood openings in the attached garage within 1.0 foot above adjacent grade <u>N/A</u>
b) No. of permanent flood openings in the crawlspace or enclosure(s) within 1.0 foot above adjacent grade <u>N/A</u>	b) No. of permanent flood openings in the attached garage within 1.0 foot above adjacent grade <u>N/A</u>	c) Total net area of flood openings in A9.b <u>N/A</u> sq in
c) Total net area of flood openings in A8.b <u>N/A</u> sq in	c) Total net area of flood openings in A9.b <u>N/A</u> sq in	d) Engineered flood openings? <input type="checkbox"/> Yes <input checked="" type="checkbox"/> No
d) Engineered flood openings? <input type="checkbox"/> Yes <input checked="" type="checkbox"/> No		

SECTION B - FLOOD INSURANCE RATE MAP (FIRM) INFORMATION					
B1. NFIP Community Name & Community Number City of Marco Island 120426		B2. County Name Collier		B3. State Florida	
B4. Map/Panel Number 12021C 0812	B5. Suffix G	B6. FIRM Index Date 11/17/2005	B7. FIRM Panel Effective/Revised Date 11/17/2005	B8. Flood Zone(s) AE	B9. Base Flood Elevation(s) (Zone AO, use base flood depth) 10'
B10. Indicate the source of the Base Flood Elevation (BFE) data or base flood depth entered in Item B9. <input type="checkbox"/> FIS Profile <input checked="" type="checkbox"/> FIRM <input type="checkbox"/> Community Determined <input type="checkbox"/> Other (Describe) _____					
B11. Indicate elevation datum used for BFE in Item B9: <input type="checkbox"/> NGVD 1929 <input checked="" type="checkbox"/> NAVD 1988 <input type="checkbox"/> Other (Describe) _____					
B12. Is the building located in a Coastal Barrier Resources System (CBRS) area or Otherwise Protected Area (OPA)? <input type="checkbox"/> Yes <input checked="" type="checkbox"/> No Designation Date _____ <input type="checkbox"/> CBRS <input type="checkbox"/> OPA					

SECTION C - BUILDING ELEVATION INFORMATION (SURVEY REQUIRED)	
C1. Building elevations are based on: <input type="checkbox"/> Construction Drawings* <input type="checkbox"/> Building Under Construction* <input checked="" type="checkbox"/> Finished Construction	
*A new Elevation Certificate will be required when construction of the building is complete.	
C2. Elevations - Zones A1-A30, AE, AH, A (with BFE), VE, V1-V30, V (with BFE), AR, AR/A, AR/AE, AR/A1-A30, AR/AH, AR/AO. Complete items C2.a-h below according to the building diagram specified in Item A7. Use the same datum as the BFE. Benchmark Utilized <u>Col 11 Vertical Datum NAVD 1988</u> Conversion/Comments _____	
Check the measurement used.	
a) Top of bottom floor (including basement, crawlspace, or enclosure floor) <u>4.5</u>	<input checked="" type="checkbox"/> feet <input type="checkbox"/> meters (Puerto Rico only)
b) Top of the next higher floor <u>13.5</u>	<input checked="" type="checkbox"/> feet <input type="checkbox"/> meters (Puerto Rico only)
c) Bottom of the lowest horizontal structural member (V Zones only) <u>N/A</u>	<input type="checkbox"/> feet <input type="checkbox"/> meters (Puerto Rico only)
d) Attached garage (top of slab) <u>N/A</u>	<input type="checkbox"/> feet <input type="checkbox"/> meters (Puerto Rico only)
e) Lowest elevation of machinery or equipment servicing the building (Describe type of equipment and location in Comments) <u>13.8</u>	<input checked="" type="checkbox"/> feet <input type="checkbox"/> meters (Puerto Rico only)
f) Lowest adjacent (finished) grade next to building (LAG) <u>4.1</u>	<input checked="" type="checkbox"/> feet <input type="checkbox"/> meters (Puerto Rico only)
g) Highest adjacent (finished) grade next to building (HAG) <u>5.1</u>	<input checked="" type="checkbox"/> feet <input type="checkbox"/> meters (Puerto Rico only)
h) Lowest adjacent grade at lowest elevation of deck or stairs, including structural support <u>N/A</u>	<input type="checkbox"/> feet <input type="checkbox"/> meters (Puerto Rico only)

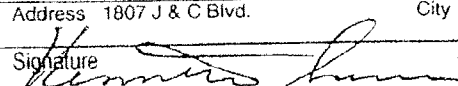SECTION D - SURVEYOR, ENGINEER, OR ARCHITECT CERTIFICATION			
This certification is to be signed and sealed by a land surveyor, engineer, or architect authorized by law to certify elevation information. I certify that the information on this Certificate represents my best efforts to interpret the data available. I understand that any false statement may be punishable by fine or imprisonment under 18 U.S. Code, Section 1001. <input checked="" type="checkbox"/>			
Check here if comments are provided on back of form.		Were latitude and longitude in Section A provided by a licensed land surveyor? <input type="checkbox"/> Yes <input checked="" type="checkbox"/> No	
Certifier's Name Kenneth Sarrio		License Number #6348	
Title Land Surveyor and Mapper	Company Name Benchmark Land Services		
Address 1807 J & C Blvd.	City Naples	State FL	ZIP Code 34109
Signature 	Date 12/29/2011	Telephone (239)-591-0778	

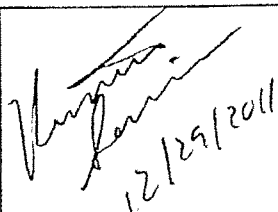  
 # 6348

**IMPORTANT: In these spaces, copy the corresponding information from Section A.**

Building Street Address (including Apt., Unit, Suite, and/or Bldg. No.) or P.O. Route and Box No.  
1240 Marlin Court

City Marco Island State FL ZIP Code 34145

For Insurance Company Use:

Policy Number

Company NAIC Number

**SECTION D - SURVEYOR, ENGINEER, OR ARCHITECT CERTIFICATION (CONTINUED)**

Copy both sides of this Elevation Certificate for (1) community official, (2) insurance agent/company, and (3) building owner.

Comments Item shown in C2.e) is A/C equipment. The lowest floor, under the main living area, with an area of 832 square feet, as shown in A8.a), and an elevation of 4.5', is used as parking. There was no access to the inside or the underside of the structure at the time measurements were taken. This structure was built prior to the current flood maps.

*Kenneth Smith*  
Signature

Date 12/29/2011

Check here if attachments

**SECTION E - BUILDING ELEVATION INFORMATION (SURVEY NOT REQUIRED) FOR ZONE AO AND ZONE A (WITHOUT BFE)**

For Zones AO and A (without BFE), complete Items E1-E5. If the Certificate is intended to support a LOMA or LOMR-F request, complete Sections A, B, and C. For Items E1-E4, use natural grade, if available. Check the measurement used. In Puerto Rico only, enter meters.

- E1. Provide elevation information for the following and check the appropriate boxes to show whether the elevation is above or below the highest adjacent grade (HAG) and the lowest adjacent grade (LAG).
  - a) Top of bottom floor (including basement, crawlspace, or enclosure) is \_\_\_\_\_  feet  meters  above or  below the HAG.
  - b) Top of bottom floor (including basement, crawlspace, or enclosure) is \_\_\_\_\_  feet  meters  above or  below the LAG.
- E2. For Building Diagrams 6-9 with permanent flood openings provided in Section A Items 8 and/or 9 (see pages 8-9 of Instructions), the next higher floor (elevation C2.b in the diagrams) of the building is \_\_\_\_\_  feet  meters  above or  below the HAG.
- E3. Attached garage (top of slab) is \_\_\_\_\_  feet  meters  above or  below the HAG.
- E4. Top of platform of machinery and/or equipment servicing the building is \_\_\_\_\_  feet  meters  above or  below the HAG.
- E5. Zone AO only: If no flood depth number is available, is the top of the bottom floor elevated in accordance with the community's floodplain management ordinance?  Yes  No  Unknown. The local official must certify this information in Section G.

**SECTION F - PROPERTY OWNER (OR OWNER'S REPRESENTATIVE) CERTIFICATION**

The property owner or owner's authorized representative who completes Sections A, B, and E for Zone A (without a FEMA-issued or community-issued BFE) or Zone AO must sign here. The statements in Sections A, B, and E are correct to the best of my knowledge.

Property Owner's or Owner's Authorized Representative's Name

Address	City	State	ZIP Code
Signature	Date	Telephone	
Comments			

Check here if attachments

**SECTION G - COMMUNITY INFORMATION (OPTIONAL)**

The local official who is authorized by law or ordinance to administer the community's floodplain management ordinance can complete Sections A, B, C (or E), and G of this Elevation Certificate. Complete the applicable item(s) and sign below. Check the measurement used in Items G8 and G9.

- G1.  The information in Section C was taken from other documentation that has been signed and sealed by a licensed surveyor, engineer, or architect who is authorized by law to certify elevation information. (Indicate the source and date of the elevation data in the Comments area below.)
- G2.  A community official completed Section E for a building located in Zone A (without a FEMA-issued or community-issued BFE) or Zone AO.
- G3.  The following information (Items G4-G9) is provided for community floodplain management purposes.

G4. Permit Number	G5. Date Permit Issued	G6. Date Certificate Of Compliance/Occupancy Issued
-------------------	------------------------	---

- G7. This permit has been issued for:  New Construction  Substantial Improvement
- G8. Elevation of as-built lowest floor (including basement) of the building: \_\_\_\_\_  feet  meters (PR) Datum \_\_\_\_\_
- G9. BFE or (in Zone AO) depth of flooding at the building site: \_\_\_\_\_  feet  meters (PR) Datum \_\_\_\_\_
- G10. Community's design flood elevation \_\_\_\_\_  feet  meters (PR) Datum \_\_\_\_\_

Local Official's Name	Title
Community Name	Telephone
Signature	Date
Comments	

Check here if attachments

## Building Photographs

See Instructions for Item A6.

Building Street Address (including Apt., Unit, Suite, and/or Bldg. No.) or P.O. Route and Box No. 1240 Marlin Court	For Insurance Company Use: Policy Number
City Marco Island State FL ZIP Code 34145	Company NAIC Number


If using the Elevation Certificate to obtain NFIP flood insurance, affix at least two building photographs below according to the instructions for Item A6. Identify all photographs with: date taken; "Front View" and "Rear View"; and, if required, "Right Side View" and "Left Side View." If submitting more photographs than will fit on this page, use the Continuation Page, following.



Front View: 12/28/2011



Rear View: 12/28/2011

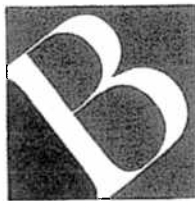

# BENCHMARK LAND SERVICES, INC.

1807 J. & C. Boulevard  
Naples, Florida 34109  
L.B. # 7502

Tel. 239-591-0778  
Fax. 239-591-1195  
www.benchmarklandservices.com

## SKETCH OF BOUNDARY SURVEY SURVEY #8568

Property Address:  
1240 Marlin Court  
Marco Island, FL 34145

Certified To:  
Vinod Rustgi

### Legal Description As Furnished:

Lot 10, Block 325, MARCO BEACH, UNIT TEN, according to the plat thereof as recorded in Plat Book 6, Pages 74-83, inclusive, of the Public Records of Collier County, Florida.

<u>DATE OF SURVEY</u>	<u>DRAWN BY</u>	<u>Flood Zone Information:</u>	
12/28/2011	G.F.	Community Number: 120426	Panel: 0812 Suffix: G
<u>COMPLETION DATE</u>	<u>CHECKED BY</u>	Effective Date: 11/17/2005	
12/29/2011	K.S.	Flood Zone: AE BFE: 10' N.A.V.D. 1988	

L-1 = S 79°12'42" W 103.15' P.  
S 79°14'53" W 103.15' M.  
L-2 = N 79°12'42" E 42.23' P.  
N 79°16'36" E 42.22' M.


BEARINGS SHOWN HEREON ARE  
BASED UPON AN ASSUMED BEARING OF  
N 79°12'42" E FOR THE SOUTH R/W OF  
MARLIN COURT.

C-1 (P.) Δ=42°50'00"  
L=18.69'  
R=25.00'

C-1 (M.) Δ=42°49'26"  
L=18.69'  
R=25.00'  
CH=S 79°33'46" E

C-2 (P.) Δ=46°53'23"  
L=40.92'  
R=50.00'

C-2 (M.) Δ=46°59'21"  
L=41.01'  
R=50.00'  
CH=S 81°15'06" E

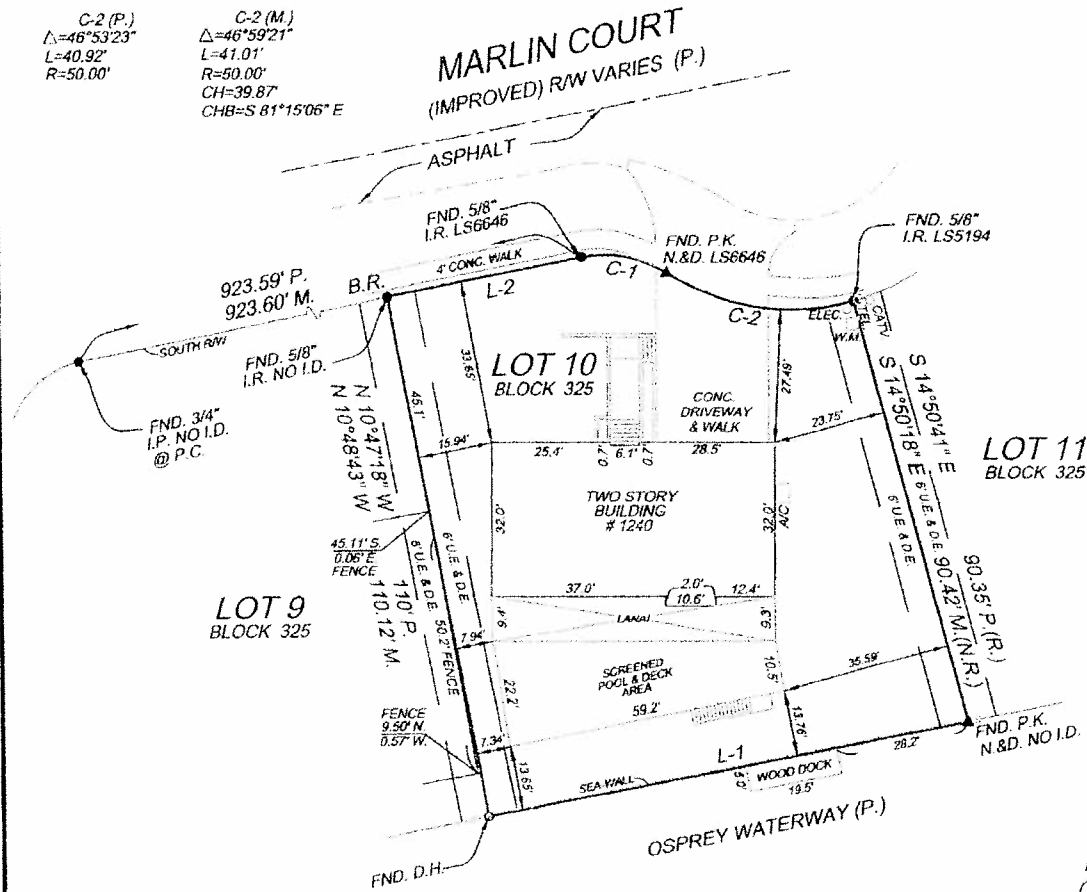


- LEGAL DESCRIPTION PROVIDED BY OTHERS. NO EXAMINATION OF TITLE MADE BY SURVEYOR. THE LANDS SHOWN HEREON WERE NOT ABSTRACTED FOR EASEMENTS OR OTHER RECORDS. ENCUMBRANCES NOT SHOWN ON THE PLAT.
- THIS CERTIFICATION IS ONLY FOR THE LANDS DESCRIBED. IT IS NOT A CERTIFICATION OF TITLE, ZONING, EASEMENTS OR FREEDOM FROM ENCUMBRANCES, OWNERSHIP, OR RIGHTS-OF-WAY.
- UNDERGROUND POSITIONS OF FOOTINGS, FOUNDATIONS OR OTHER IMPROVEMENTS WERE NOT LOCATED. WALL DEPTHS TO THE FACE OF THE WALL AND ARE NOT TO BE USED TO RECONSTRUCT BOUNDARY LINES.
- NOT VALID WITHOUT THE SIGNATURE & ORIGINAL RAISED SEAL OF A FLORIDA LICENSED SURVEYOR AND MAPPER.
- ONLY VISIBLE ENCUMBRANCES LOCATED.
- THIS SURVEY IS INTENDED FOR MORTGAGE OR REFERENCE PURPOSES ONLY. EXCLUSIVELY FOR THIS USE BY THOSE TO WHOM IT IS CERTIFIED. THIS SURVEY IS NOT TO BE USED FOR CONSTRUCTION, PERMITTING, DESIGN OR ANY OTHER USE WITHOUT WRITTEN CONSENT.
- NO EPCRA WAS MADE TO PRIOR PLAT BOUNDARIES.
- ONLY IMPROVEMENTS SHOWN WERE LOCATED.
- DIMENSIONS ARE IN FEET AND DECIMALS THEREOF.
- PARCELS SUBJECT TO EASEMENTS, RESTRICTIONS, RESERVATIONS, AND HEIGHT-OF-WAYS OF RECORD.
- EASEMENTS SHOWN ON THIS DRAWING ARE FROM THE RECORDS & PLAT. ANY OTHER EASEMENT (S) PERTAINING TO THE HEREON DESCRIBED LAND (S) MUST BE FURNISHED TO THE SURVEYOR BY THE CLIENT OR THE CLIENTS AGENT PER FLORIDA STATUTE (FC) 17.051 (4) OF THE FLORIDA ADMINISTRATIVE CODE.
- ADDITIONS OR DELETIONS TO SURVEY MAPS OR REPORTS BY OTHERS THAN THE SIGNING PARTY OR PARTIES IS PROHIBITED WITHOUT WRITTEN CONSENT OF THE SIGNING PARTY OR PARTIES.
- PARCEL WAS SURVEYED FROM INFORMATION SUPPLIED BY THE CLIENT.
- FENCE OWNERSHIP NOT DETERMINED.

### POINTS OF INTEREST:

I hereby certify that A Survey of the hereon described property was made under my direction and meets the Minimum Technical Standards as per Chapter 51-17.051 & .052 F.A.C., pursuant to section 472.027, Florida Statutes.

*Kenneth Sarriso* 12/29/2011

**KENNETH SARRISO**  
Professional Surveyor and Mapper PSM No. 6348 State of Florida

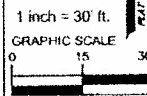

BR	BEARING REFERENCE	IP	IRON PIPE	PI	POINT OF INTERSECTION	UE	UTILITY EASEMENT	EW	EDGE OF PAVEMENT
C	CALCULATED	AE	ACCESS EASEMENT	P.I.S.	PROFESSIONAL LAND SURVEYOR	WA	WATER METER	WV	WATER VALVE
CATV	CABLE TV METER	LB	LAND SURVEYING BUSINESS	P.T.	POINT OF TANGENCY	F	FENCE	WP	WELL
C.U.E.	COUNTY UTILITY ESMT.	L.B.F.	LANDSCAPE BUFFER ESMT.	P.O.B.	POINT OF BEGINNING	PE	PAST EXISTING ELEVATION	W	EXISTING FIRE HYDRANT
D.E.	DRAINAGE EASEMENT	L.C.U.E.	LEE COUNTY UTILITY EASEMENT	P.O.C.	POINT OF COMPLETION	PE	PROPOSED ELEVATION	R	RADIAL
D.H.	DRILL HOLE	M.E.	METERED END	P.R.C.	POINT OF REVERSE CURVATURE	NR	NON-RADIAL	C.V.G.	CONCRETE VALLEY CUTTER
ELEC.	ELECTRIC BOX	N.A.L.	NAIL & DISK	P.R.M.	PERMANENT REFERENCE MONUMENT	C.M.	CATCH BASIN	S.D.	STORM DRAIN
FENCE	ENCLOSURE	O.H.L.	OVERHEAD LINE	P.U.E.	PUBLIC UTILITY EASEMENT	C.M.	CONCRETE MONUMENT	C.D.	CATCH BASIN
F.O.W.	EDGE OF WATER	P.L.	POINT OF CURVATURE	R.W.	RIGHT OF WAY	C.O.	CLEAN OUT		
F.P.	FURNISHED FLOOR	P.C.	POINT OF CURVATURE	C.U.F.	CUSTOMER UTILITY ESMT. UTR. ESMT.				
FND.	FOUNDATION	P.C.C.	POINT OF COMPOUND CURVATURE	V.E.	VEGETATION EASEMENT				
I.D.	IDENTIFICATION	P.C.P.	POINT OF COMPOUND CURVATURE	T.B.M.	TEMPORARILY BENCHMARK				
I.R.	IRON ROD	P.V.	PARALLEL ON NAIL	T.E.L.	TELEPHONE ENCLOSURES				
				T.O.B.	TOP OF BANK				