

073345

ELEVATION CERTIFICATE

OMB No. 1660-0008
Expires February 28, 2009

Important: Read the instructions on pages 1-8.

SECTION A - PROPERTY INFORMATION

A1. Building Owner's Name <u>MARRIOTT OWNERSHIP RESORTS INC.</u>		For Insurance Company Use: Policy Number
A2. Building Street Address (including Apt., Unit, Suite, and/or Bldg. No.) or P.O. Route and Box No. <u>600 COLLIER BLVD. SOUTH</u> City <u>MARCO ISLAND</u> State <u>FL</u> ZIP Code <u>34145</u>		Company NAIC Number
A3. Property Description (Lot and Block Numbers, Tax Parcel Number, Legal Description, etc.) <u>COLLIER COUNTY STRAP NO. 811490016.0007B18 O.R. BOOK 4074, PAGE 3304</u>		
A4. Building Use (e.g., Residential, Non-Residential, Addition, Accessory, etc.) <u>RESIDENTIAL</u>		
A5. Latitude/Longitude: Lat. <u>25°-55'-14.6"N</u> Long. <u>81°-43'40.8"W</u>		Horizontal Datum: <input type="checkbox"/> NAD 1927 <input checked="" type="checkbox"/> NAD 1983
A6. Attach at least 2 photographs of the building if the Certificate is being used to obtain flood insurance.		
A7. Building Diagram Number <u>6</u>		
A8. For a building with a crawl space or enclosure(s), provide		A9. For a building with an attached garage, provide:
a) Square footage of crawl space or enclosure(s) <u>N/A</u> sq ft		a) Square footage of attached garage <u>N/A</u> sq ft
b) No. of permanent flood openings in the crawl space or enclosure(s) walls within 1.0 foot above adjacent grade <u>N/A</u>		b) No. of permanent flood openings in the attached garage walls within 1.0 foot above adjacent grade <u>N/A</u>
c) Total net area of flood openings in A8.b <u>N/A</u> sq in		c) Total net area of flood openings in A9.b <u>N/A</u> sq in

See attached floodproofing certificate

SECTION B - FLOOD INSURANCE RATE MAP (FIRM) INFORMATION

B1. NFIP Community Name & Community Number <u>CITY OF MARCO ISLAND 120426</u>		B2. County Name <u>COLLIER</u>		B3. State <u>FLORIDA</u>	
B4. Map/Panel Number <u>12021C0811</u>	B5. Suffix <u>G</u>	B6. FIRM Index Date <u>11/17/2005</u>	B7. FIRM Panel Effective/Revised Date <u>11/17/2005</u>	B8. Flood Zone(s) <u>AE</u>	B9. Base Flood Elevation(s) (Zone AO, use base flood depth) <u>13.3 NGVD-29</u>
B10. Indicate the source of the Base Flood Elevation (BFE) data or base flood depth entered in Item B9. <input type="checkbox"/> FIS Profile <input checked="" type="checkbox"/> FIRM <input type="checkbox"/> Community Determined <input type="checkbox"/> Other (Describe) _____					
B11. Indicate elevation datum used for BFE in Item B9: <input checked="" type="checkbox"/> NGVD 1929 <input type="checkbox"/> NAVD 1988 <input type="checkbox"/> Other (Describe) _____					
B12. Is the building located in a Coastal Barrier Resources System (CBRS) area or Otherwise Protected Area (OPA)? <input type="checkbox"/> Yes <input checked="" type="checkbox"/> No Designation Date <u>N/A</u> <input type="checkbox"/> CBRS <input type="checkbox"/> OPA					

SECTION C - BUILDING ELEVATION INFORMATION (SURVEY REQUIRED)

C1. Building elevations are based on: Construction Drawings* Building Under Construction* Finished Construction
*A new Elevation Certificate will be required when construction of the building is complete.

C2. Elevations - Zones A1-A30, AE, AH, A (with BFE), VE, V1-V30, V (with BFE), AR, AR/A, AR/AE, AR/A1-A30, AR/AH, AR/AO. Complete Items C2.a-g below according to the building diagram specified in Item A7.
Benchmark Utilized N/A Vertical Datum NGVD 1929
Conversion/Comments N/A

Check the measurement used.


a) Top of bottom floor (including basement, crawl space, or enclosure floor)	<u>10.5</u>	<input checked="" type="checkbox"/> feet <input type="checkbox"/> meters (Puerto Rico only)
b) Top of the next higher floor	<u>24.5</u>	<input checked="" type="checkbox"/> feet <input type="checkbox"/> meters (Puerto Rico only)
c) Bottom of the lowest horizontal structural member (V Zones only)	<u>N.A</u>	<input type="checkbox"/> feet <input type="checkbox"/> meters (Puerto Rico only)
d) Attached garage (top of slab)	<u>N.A</u>	<input type="checkbox"/> feet <input type="checkbox"/> meters (Puerto Rico only)
e) Lowest elevation of machinery or equipment servicing the building (Describe type of equipment in Comments)	<u>11.1</u>	<input checked="" type="checkbox"/> feet <input type="checkbox"/> meters (Puerto Rico only)
f) Lowest adjacent (finished) grade (LAG)	<u>8.0</u>	<input checked="" type="checkbox"/> feet <input type="checkbox"/> meters (Puerto Rico only)
g) Highest adjacent (finished) grade (HAG)	<u>10.4</u>	<input checked="" type="checkbox"/> feet <input type="checkbox"/> meters (Puerto Rico only)

COPY

SECTION D - SURVEYOR, ENGINEER, OR ARCHITECT CERTIFICATION

This certification is to be signed and sealed by a land surveyor, engineer, or architect authorized by law to certify elevation information. I certify that the information on this Certificate represents my best efforts to interpret the data available. I understand that any false statement may be punishable by fine or imprisonment under 18 U.S. Code, Section 1001.

Check here if comments are provided on back of form.


Certifier's Name <u>STEPHEN E. BERRY</u>	License Number <u>5269</u>
Title <u>LICENSED SURVEYOR</u>	Company Name <u>BBL S SURVEYORS & MAPPERS</u>
Address <u>1502 A- RAILHEAD BLVD.</u>	City <u>NAPLES</u> State <u>FL</u> ZIP Code <u>34110</u>
Signature 	Date <u>12/4/2008</u> Telephone <u>239-597-1315</u>

PLACE
HERE
5206
12/04/08


Building Photographs

See Instructions for Item A6.

Building Street Address (including Apt., Unit, Suite, and/or Bldg. No.) or P.O. Route and Box No. 600 COLLIER BLVD SOUTH	For Insurance Company Use: Policy Number
City MARCO ISLAND State FL ZIP Code 34145	Company NAIC Number
If using the Elevation Certificate to obtain NFIP flood insurance, affix at least two building photographs below according to the instructions for Item A6. Identify all photographs with: date taken; "Front View" and "Rear View"; and, if required, "Right Side View" and "Left Side View." If submitting more photographs than will fit on this page, use the Continuation Page, following.	

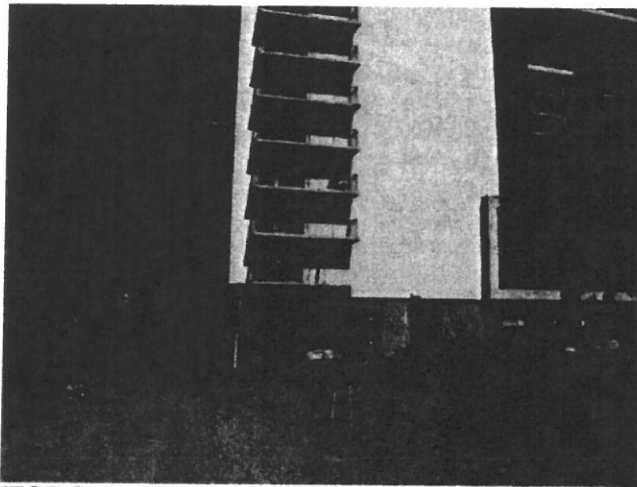

WEST SIDE OF BUILDING FACING NORTH 11/27/2008

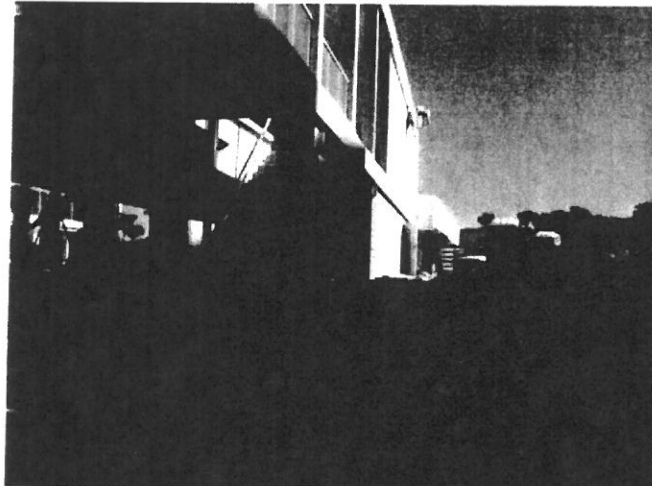

NORTHERLY SIDE OF BUILDING FACING WEST 11/27/2008



Partners
Robert M. Coleman III, A.I.A.
Gary Gilbert, A.I.A., M.B.A.
Marvin R. Ragland Jr., A.I.A.
Dale M. Songy, A.I.A.

Associates
Joseph Saffiotti, A.I.A.
Jonathan M. Heltz, A.I.A.
Wendy H. Lee, A.I.A.
Christopher M. Haslitt, A.I.A.

December 9, 2008

City of Marco Island
50 Bald Eagle Drive
Marco Island, FL 34145

RE: Marriott Vacation Club Crystal Shores
600 Collier Blvd
Flood Gate Installations
Permit # 073345

Coleman & Partners

Gentlemen:

Architects
A.I.A.

Per the request for the City of Marco Island, I do hereby confirm that flood gates have been provided and installed at the locations as indicated on permit drawings.

Attached to this correspondence are drawings showing the location that flood gate panels will be stored.

Sincerely yours,

Robert M. Coleman III
Architect, AIA

3377 North Blvd.
Baton Rouge,
Louisiana 70806
USA

tel 225.387.4414
fax 225.387.4693

FEDERAL EMERGENCY MANAGEMENT AGENCY
NATIONAL FLOOD INSURANCE PROGRAM
FLOODPROOFING CERTIFICATE
FOR NON-RESIDENTIAL STRUCTURES

The floodproofing of non-residential buildings may be permitted as an alternative to elevating to or above the Base Flood Elevation; however, a floodproofing design certification is required. This form is to be used for that certification. Floodproofing of a residential building does not alter a community's floodplain management elevation requirements or affect the insurance rating unless the community has been issued an exception by FEMA to allow floodproofed residential basements. The permitting of a floodproofed residential basement requires a separate certification specifying that the design complies with the local floodplain management ordinance.

Marriott Ownership Resorts Inc.
BUILDING OWNER'S NAME
6649 Westwood Blvd
STREET ADDRESS (including Apt., Unit, Suite, and/or Bldg. Number) OR P.O. ROUTE AND BOX NUMBER
6005 Collier Blvd, Marco Island FL 34145
OTHER DESCRIPTION (Lot and Block Numbers, etc.)
CITY Orlando STATE FL ZIP CODE 32821

FOR INSURANCE COMPANY USE
POLICY NUMBER
COMPANY NAIC NUMBER

SECTION I FLOOD INSURANCE RATE MAP (FIRM) INFORMATION

Provide the following from the proper FIRM:

COMMUNITY NUMBER	PANEL NUMBER	SUFFIX	DATE OF FIRM INDEX	FIRM ZONE	BASE FLOOD ELEVATION (In AO Zones, Use Depth) EI 13.3 NGVD 29
120426	0811	G	11-17-2005	AE	

SECTION II FLOODPROOFING INFORMATION (By a Registered Professional Engineer or Architect)

Floodproofing Design Elevation Information:

Building is floodproofed to an elevation of 14.3 feet NGVD. (Elevation datum used must be the same as that on the FIRM.)
Height of floodproofing on the building above the lowest adjacent grade is 5.8 feet.

(NOTE: for insurance rating purposes, the building's floodproofed design elevation must be at least one foot above the Base Flood Elevation to receive rating credit. If the building is floodproofed only to the Base Flood Elevation, then the building's insurance rating will result in a higher premium.)

SECTION III CERTIFICATION (By Registered Professional Engineer or Architect)


Non-Residential Floodproofed Construction Certification:

I certify that, based upon development and/or review of structural design, specifications, and plans for construction, the design and methods of construction are in accordance with accepted standards of practice for meeting the following provisions:


The structure, together with attendant utilities and sanitary facilities, is watertight to the floodproofed design elevation indicated above, with walls that are substantially impermeable to the passage of water.


All structural components are capable of resisting hydrostatic and hydrodynamic flood forces, including the effects of buoyancy, and anticipated debris impact forces.

I certify that the information on this certificate represents my best efforts to interpret the data available. I understand that any false statement may be punishable by fine or imprisonment under 18 U.S. Code, Section 1001.

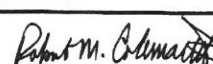
CERTIFIER'S NAME Robert M. Coleman III	LICENSE NUMBER (or Affix Seal) AR0015518		
TITLE Architect	COMPANY NAME Coleman Partners Architects		
ADDRESS 3377 North Blvd.	CITY Baton Rouge	STATE LA	ZIP CODE 70806
SIGNATURE 	DATE Dec. 10, 2008	PHONE 225-387-4414	


Copies should be made of this Certificate for: 1) community official, 2) insurance agent/company, and 3) building owner.

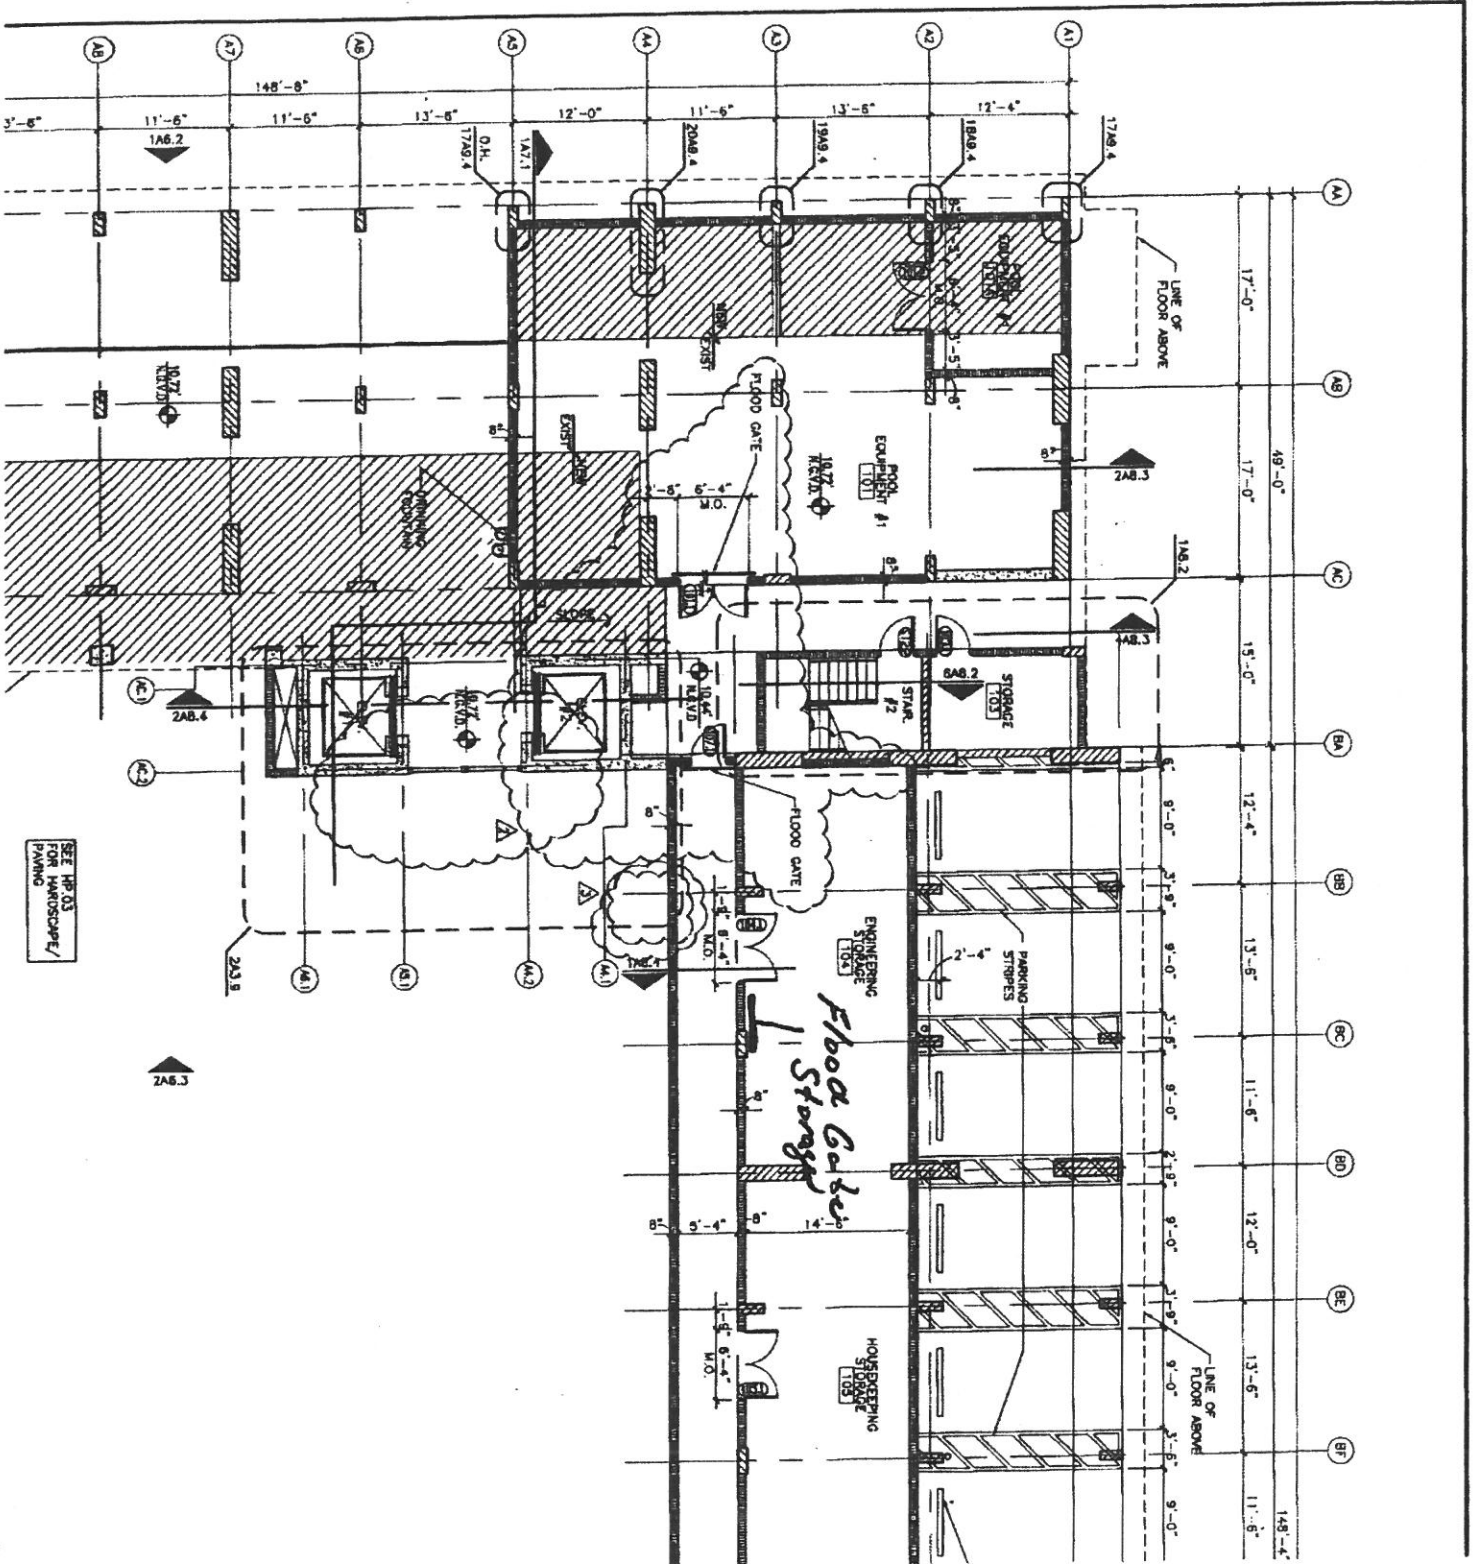

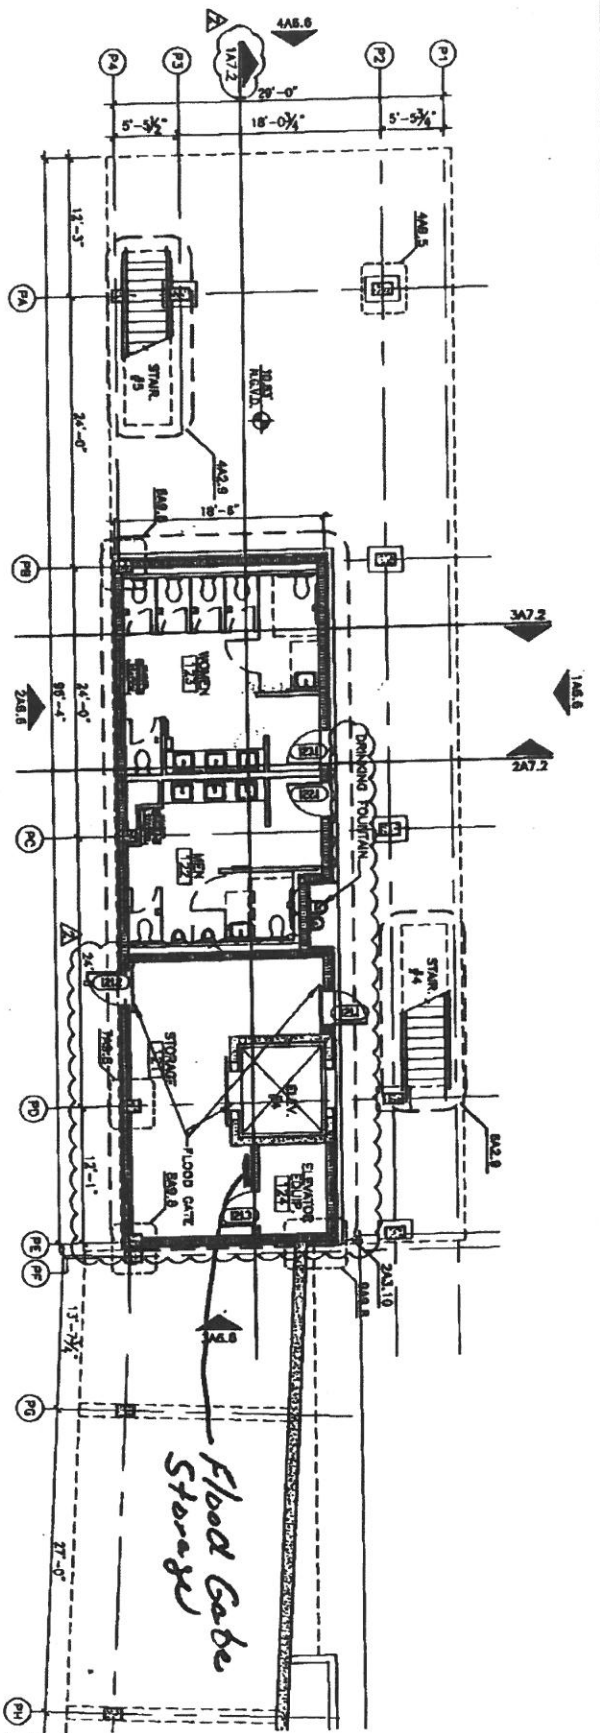

N
 1 GROUND LEVEL
 SCALE: 1/8" = 1'-0"

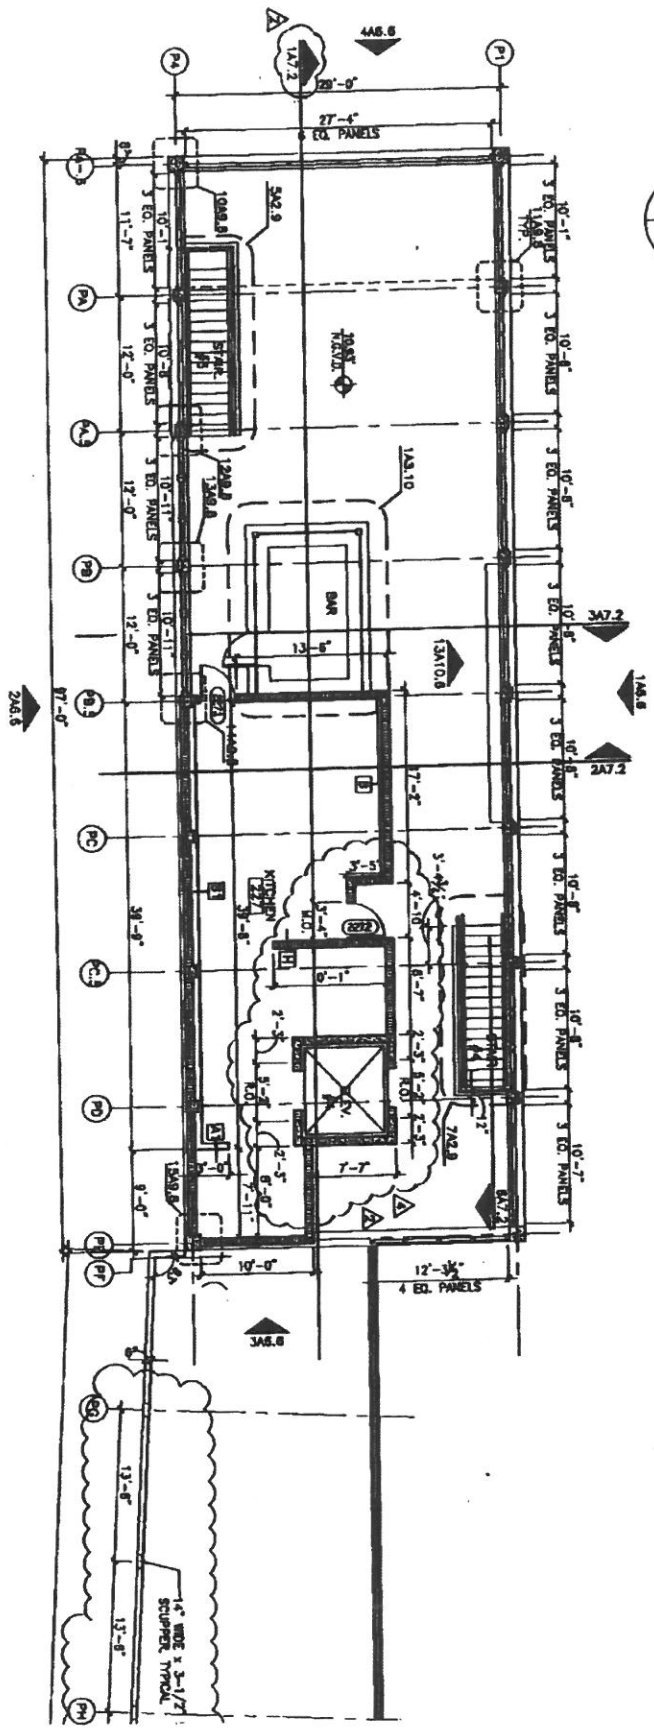

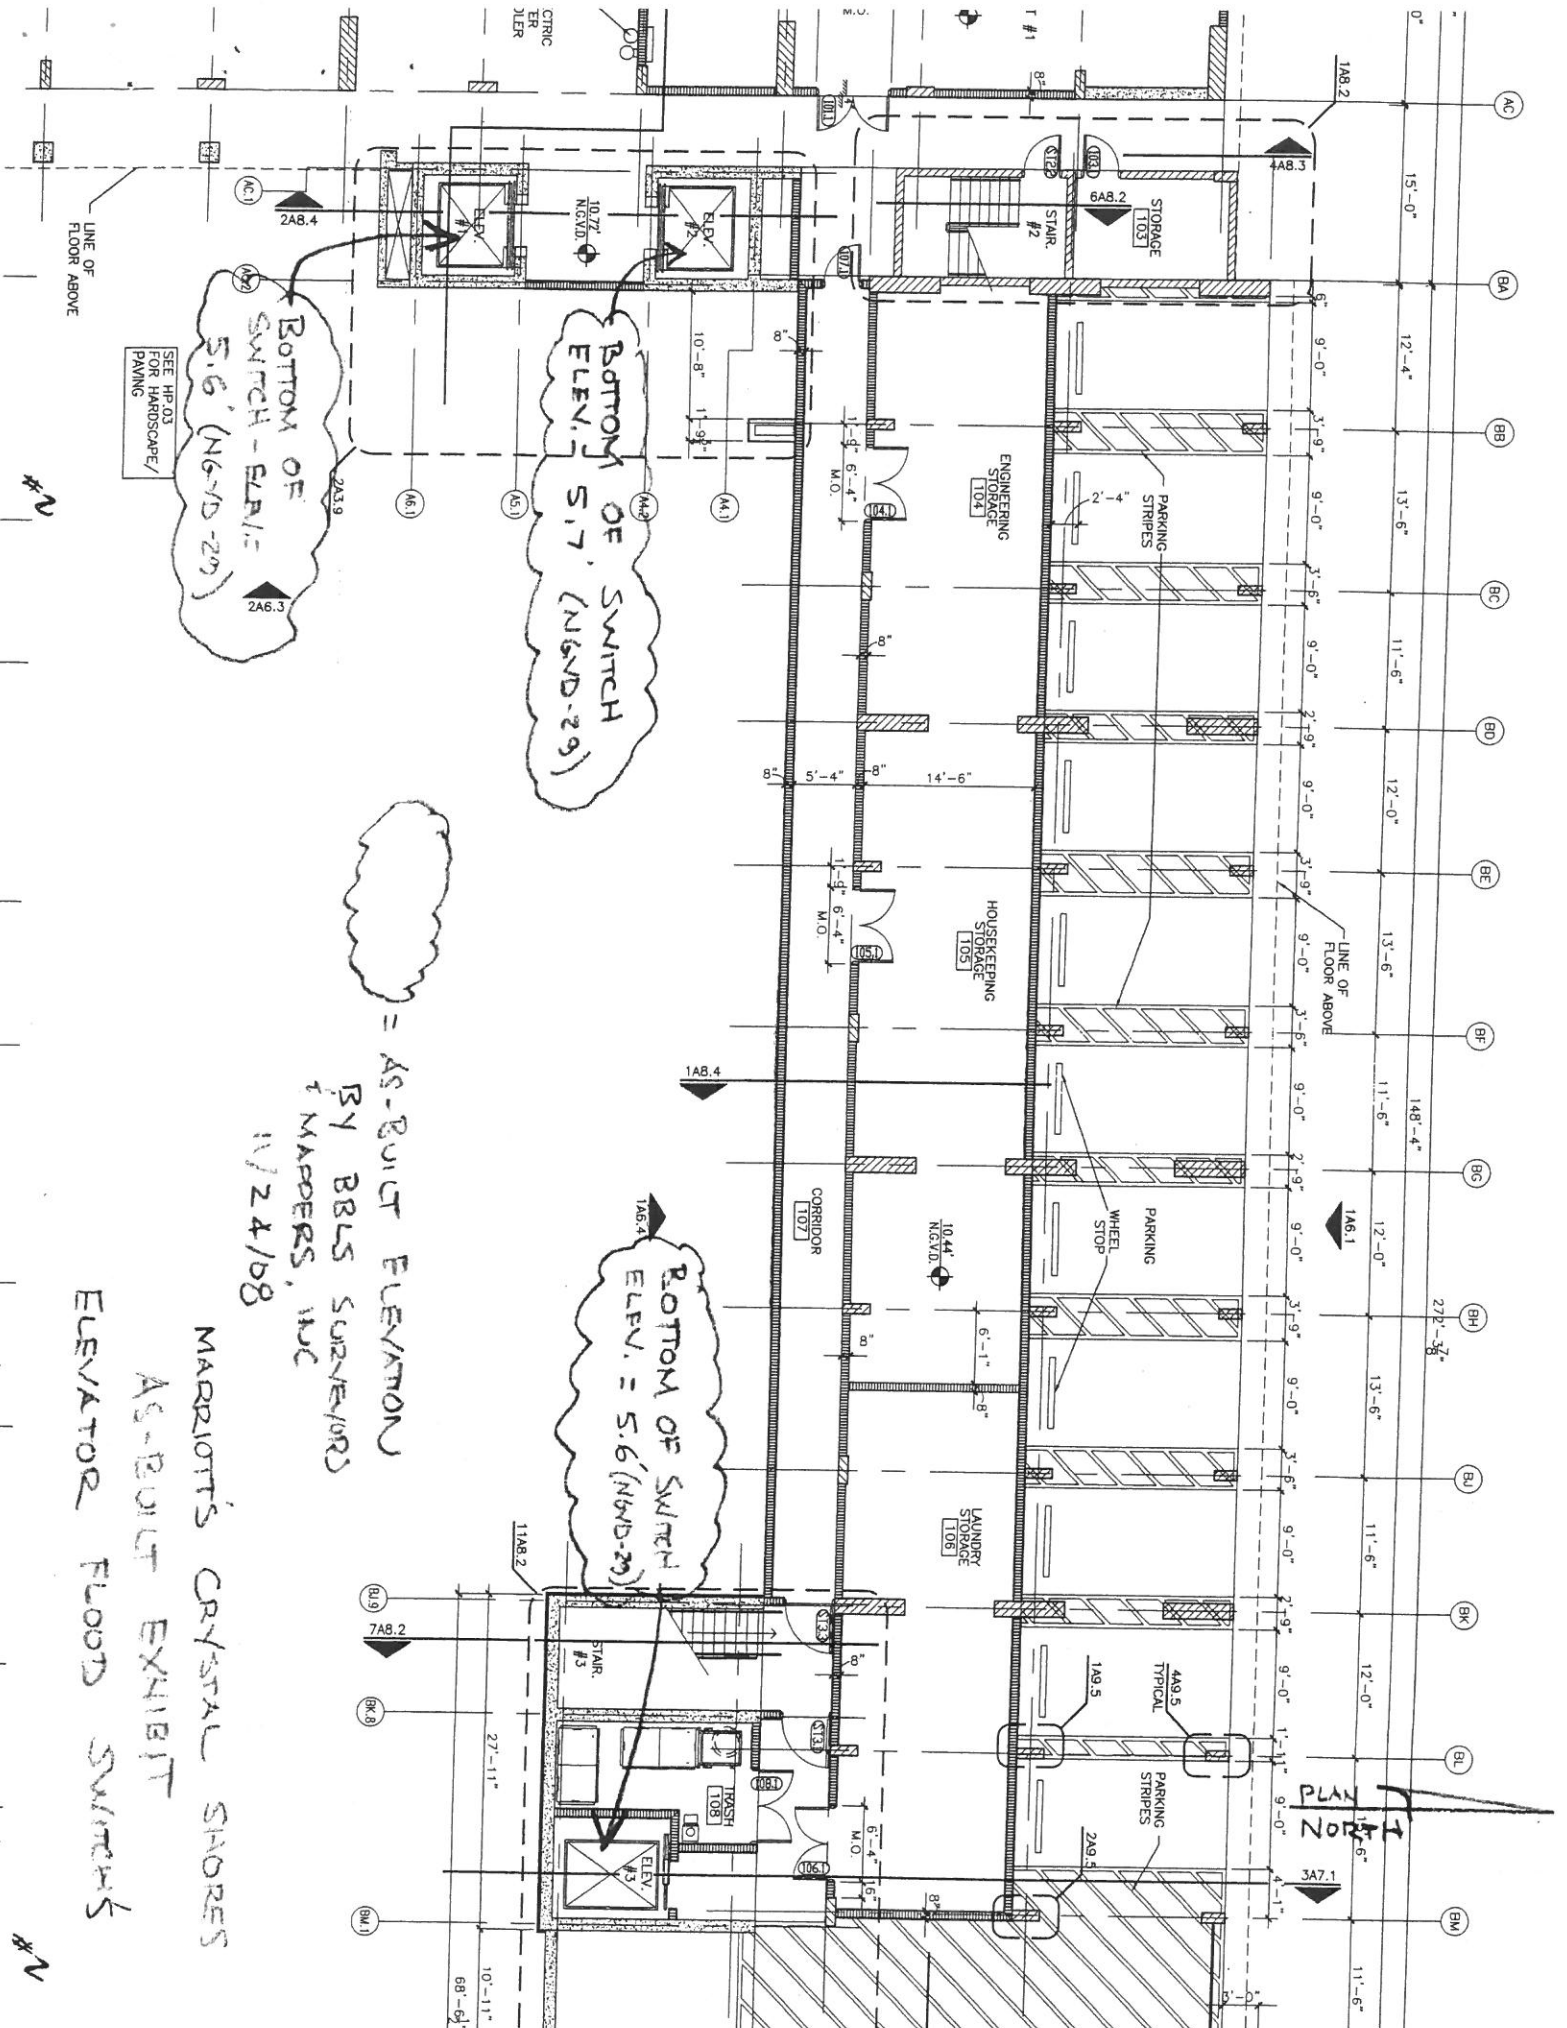

BOTTOM OF SWITCH - ELEV. = 5.6 (N&D-29)

BOTTOM OF SWITCH ELEV. = 5.6 (N&D-29)

BOTTOM OF SWITCH ELEV. = 5.6 (N&D-29)

AS-BUILT ELEVATION
 BY BLS SURVEYORS
 1/24/08

MARRIOTT'S CRYSTAL SHORES
 AS-BUILT EXHIBIT
 ELEVATOR FLOOD SWITCHES

PLAN NORTH

SEE HP-03 FOR HARDSCAPE/PAVING


LINE OF FLOOR ABOVE

LINE OF FLOOR ABOVE

#N

#N

PLAN
North

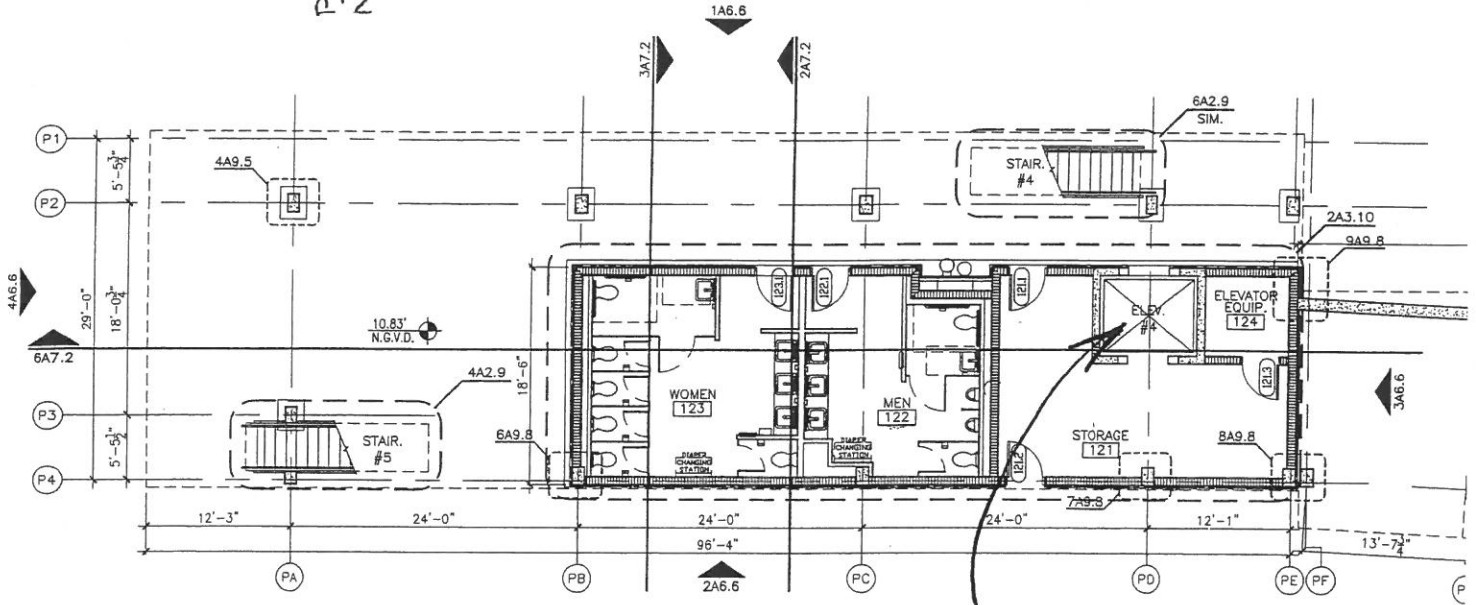

1 GROUND LEVEL
SCALE: 1/8" = 1'-0"

BOTTOM OF SWITCH
ELEV. = 7.3' (N6VD29)

= AS-BUILT ELEVATION
BY RBLS SURVEYORS
& MAPPERS, INC.
11/24/08

MARRIOTT'S CRYSTAL SHORES
AS-BUILT EXHIBIT
ELEVATOR FLOOD SWITCH